



Direccion de Redes Sanitarias y Gas

Calle : Pùblica N° 4 de calle Pùblica N°2 a Pùblica N°1

Colectora P.V.C. Ø 160 mm N° de Conexiones : 9

Contratista: Hidromat S.A.

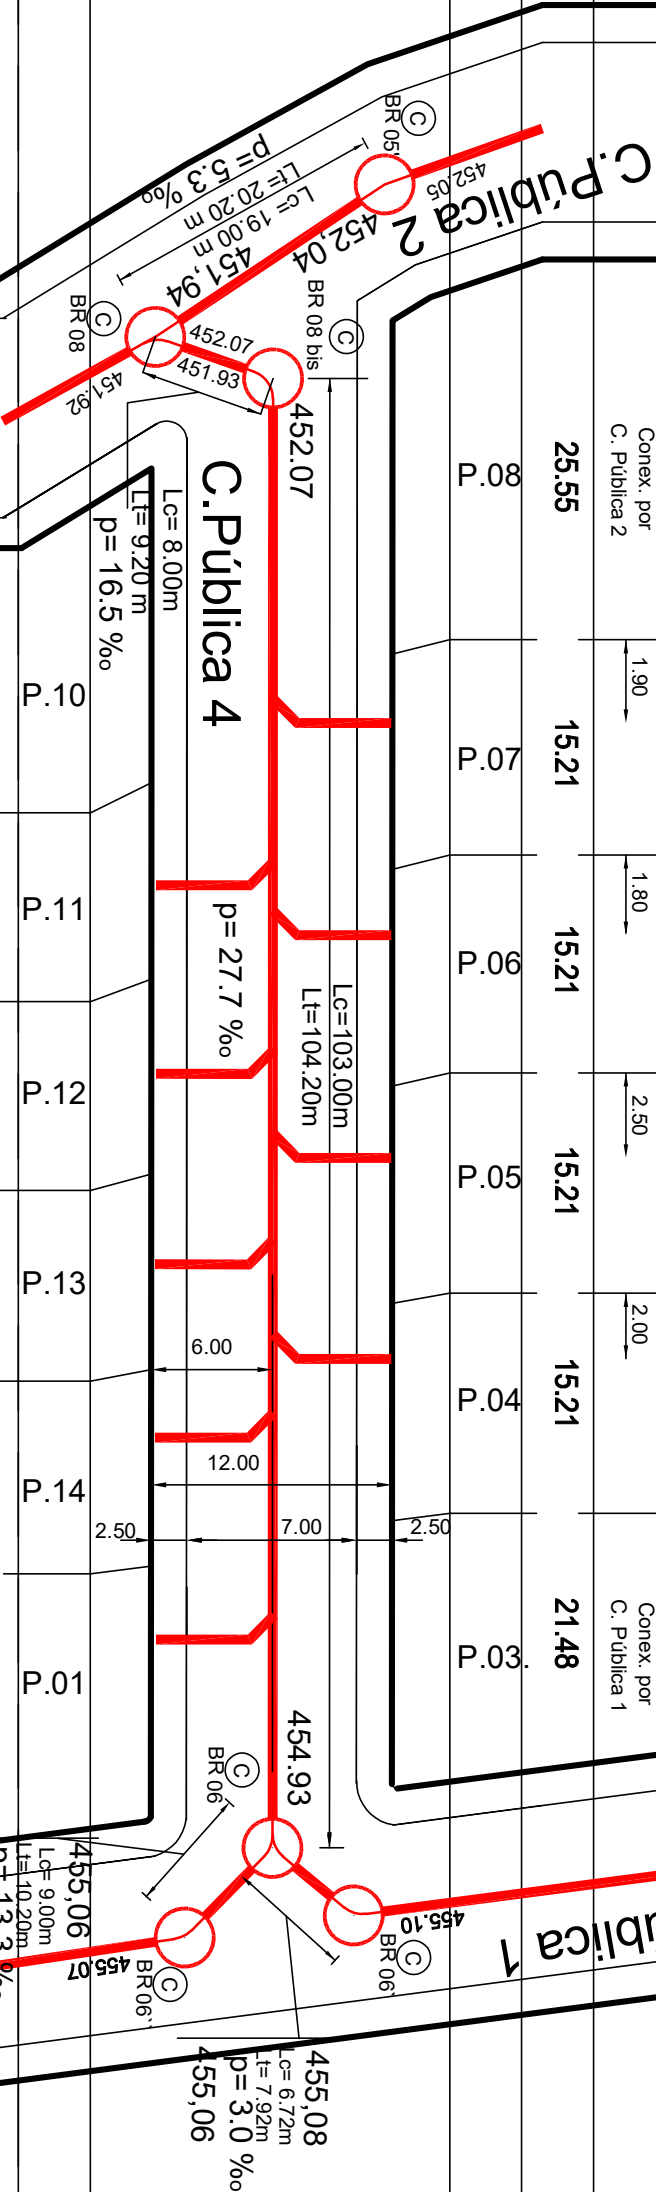
BR 05 bis a BRE 08 Ø 160 Lc= 19.00m p= 5.3 ‰

BR 06 a Bre 08 bis Ø 160 Lc= 103.00 m p= 27.7 ‰

BR 08 bis a BRE 08 Ø 160 Lc=8.00 m p=16.5 %

BR 06' a BR 06 Ø 160 Lc= 6.72 m p= 3.0 ‰

BR 06" a BR 06 Ø 160 Lc= 9.00 m p= 13.3 %

[illegible][illegible]